


PLAN
No Scale

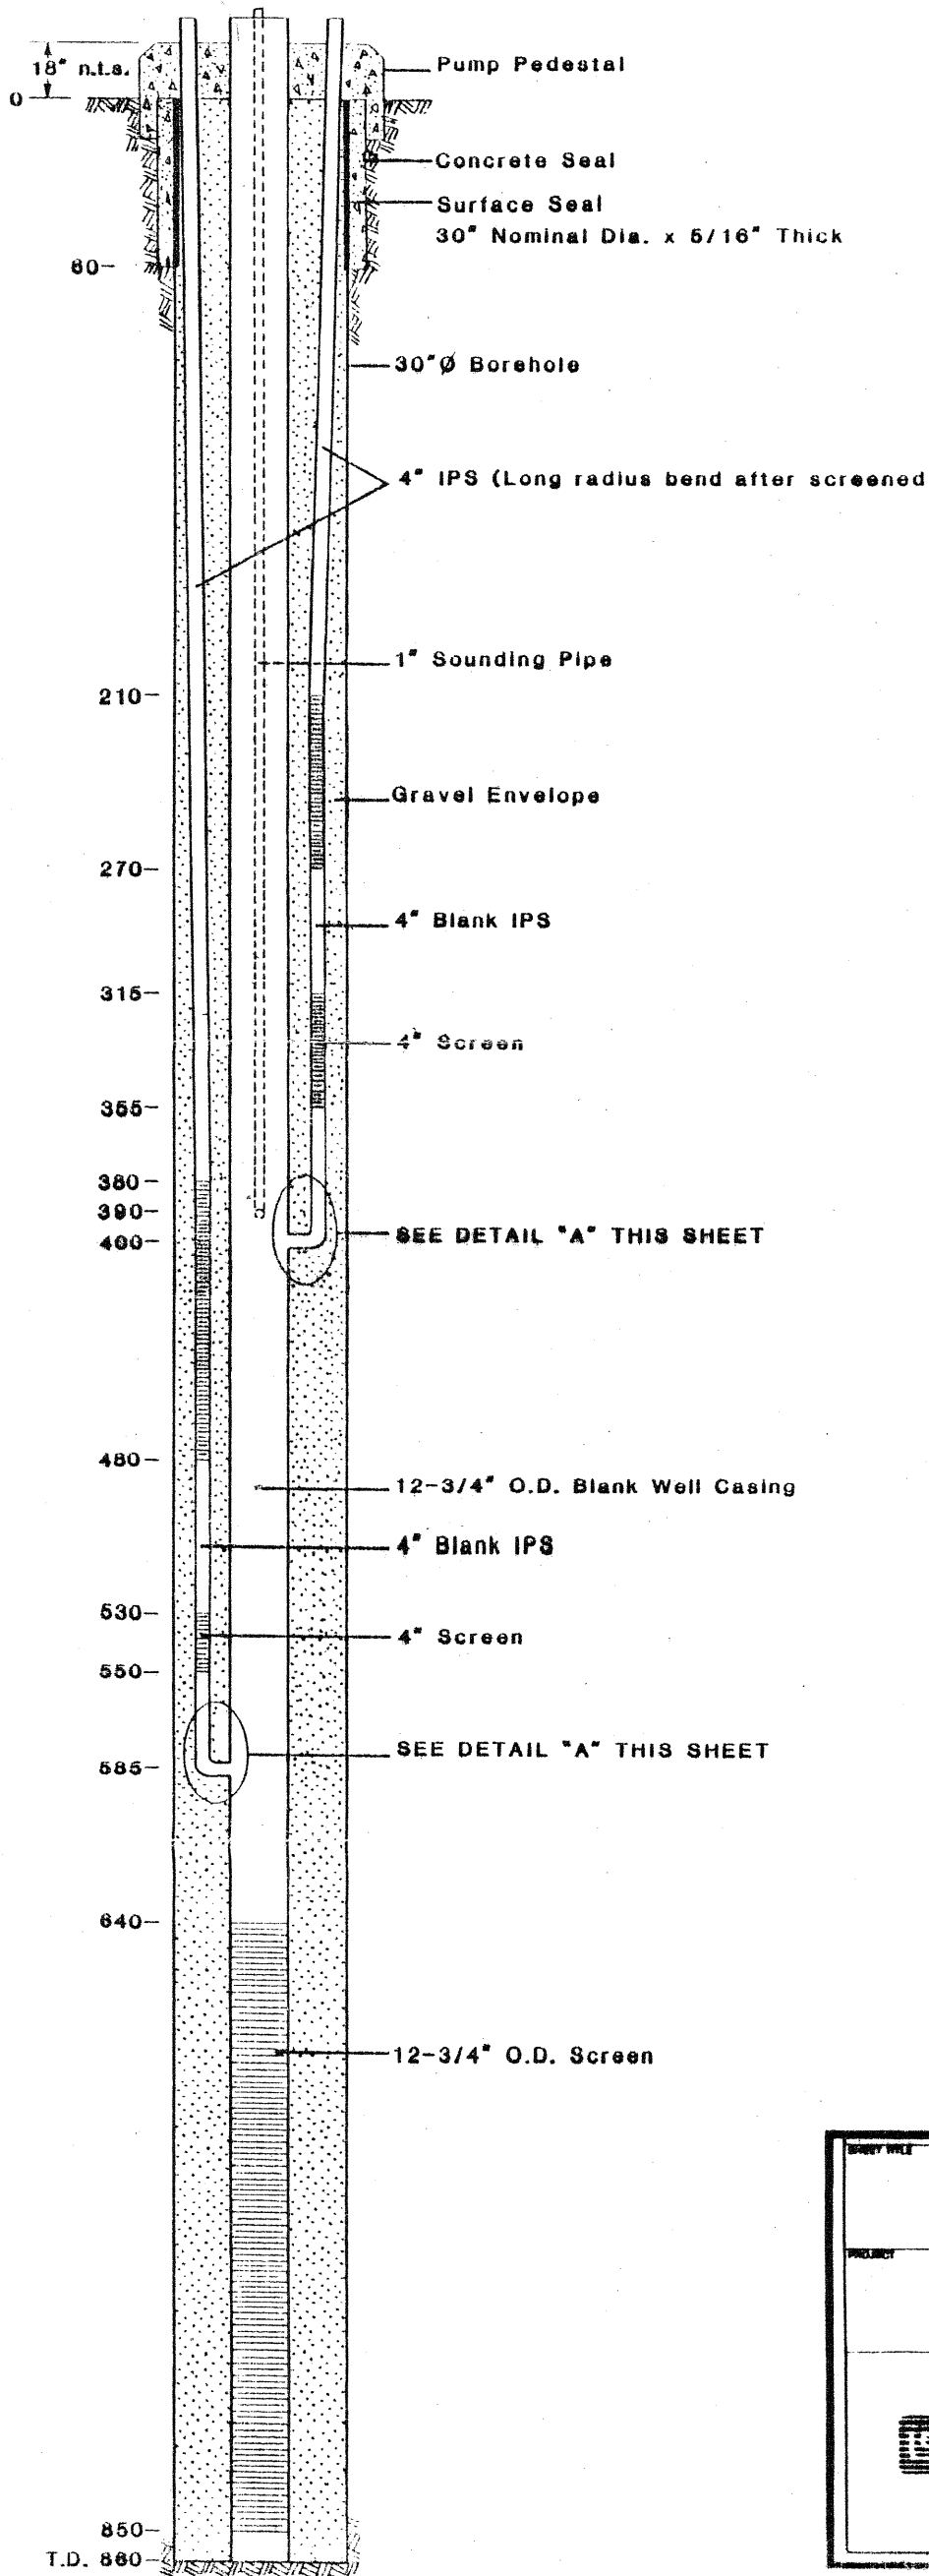

<p>Ledyard Well Production Well As-Built Construction Details</p>		<p>PROJECT NO.</p>
<p>Soquel Creek Water District Soquel, California</p>		<p>SCALE</p>
<p>LUHDORFF & SCALMANINI Consulting Engineers Woodland, California 95695</p>		<p>DATE</p>
<p>T.D. 860</p>		<p>DRAWN BY</p>
		<p>CHECKED BY</p>
		<p>DATE</p>
		<p>PROJECT NO.</p>
		<p>OF SHEETS</p>